


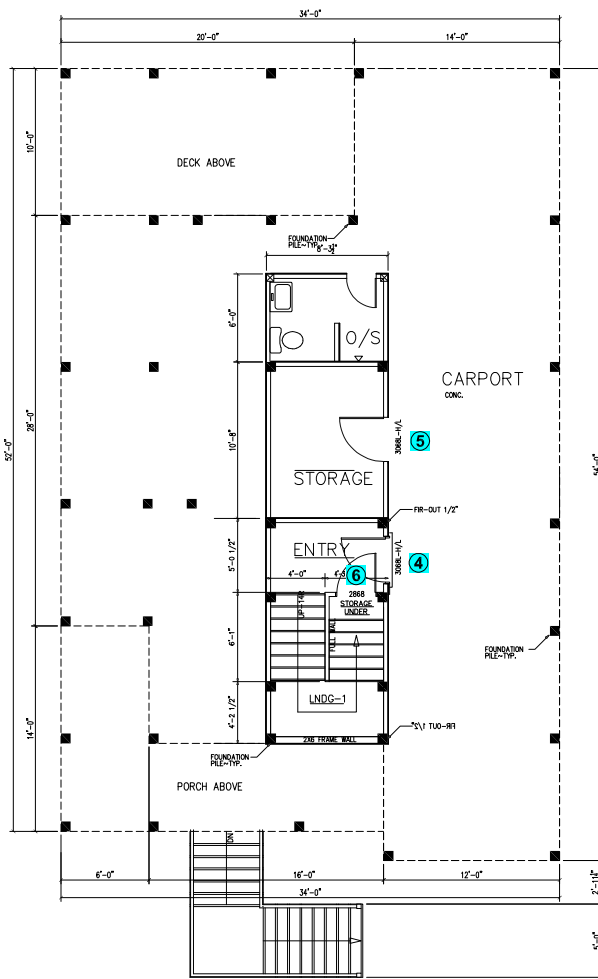


**GROUND FLOOR PLAN**

SCALE: 1/4"=1'0"

**GROUND FLOOR NOTES**

CEILING HEIGHT: 8'-1-1/2" (varies)  
 WALL HEIGHT: 8'-1-1/2" (varies)  
 EXTERIOR WALL FRAMING: 2"x4" STUDS@16" O.C. (u.n.o.)  
 INTERIOR WALL FRAMING: 2"x4" STUDS@16" O.C. (u.n.o.)  
 FLOOR SYSTEM: (see slab plan for details)  
 CEILING SYSTEM: (provided by floor above)  
 BEAMS/GIRDERS: (see foundation plan for details)  
 PLINGS-DECK&HOUSE: 6"-10" A.F.F. (u.n.o.)  
 WINDOW HEADERS: SEE DETAILS D-5 or E-5

**GROUND FLOOR AREAS**

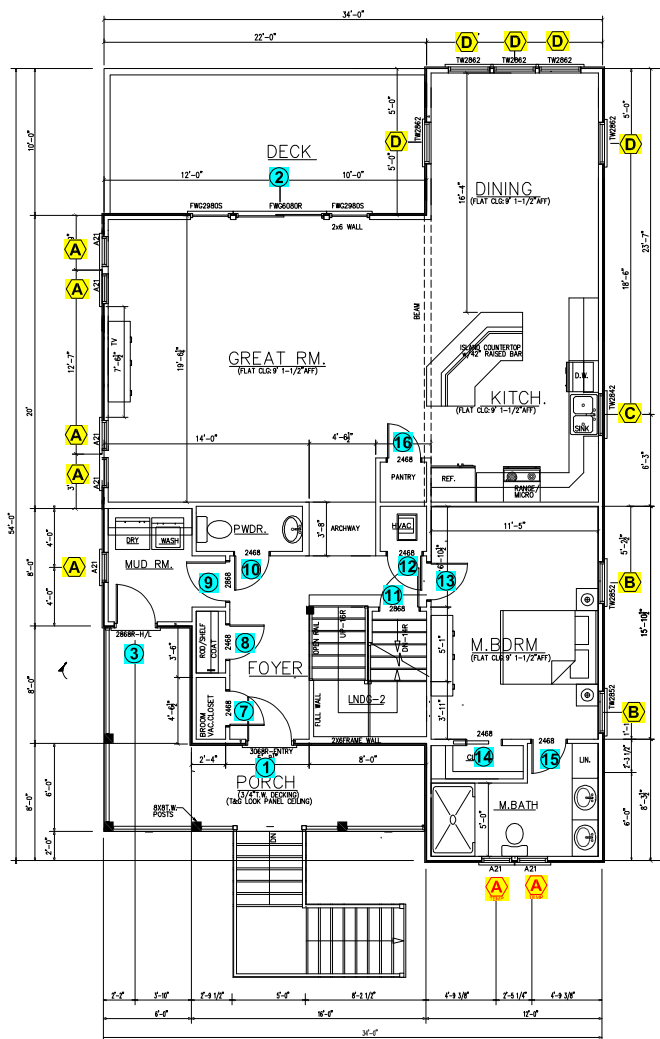

**FIRST FLOOR PLAN**


SCALE: 1/4"=1'0"

**FIRST FLOOR NOTES**

CEILING HEIGHT: 8'-1-1/2" (typical)  
 WALL HEIGHT: 8'-1-1/2" (typical)  
 EXTERIOR WALL FRAMING: 2"x4" STUDS@16" O.C. (u.n.o.)  
 INTERIOR WALL FRAMING: 2"x4" STUDS@16" O.C. (u.n.o.)  
 FLOOR SYSTEM: (see floor-1 framing for details)  
 CEILING SYSTEM: (provided by floor above)  
 BEAMS/GIRDERS: (see plans)  
 PLINGS-DECK&HOUSE: 6"-10" A.F.F. (u.n.o.)  
 WINDOW HEADERS: SEE DETAILS D-5 or E-5

**FIRST FLOOR AREAS**

AREA: 1392.0 sq. ft.  
 PORCH: 180.0 sq. ft.  
 DECK: 220.0 sq. ft.

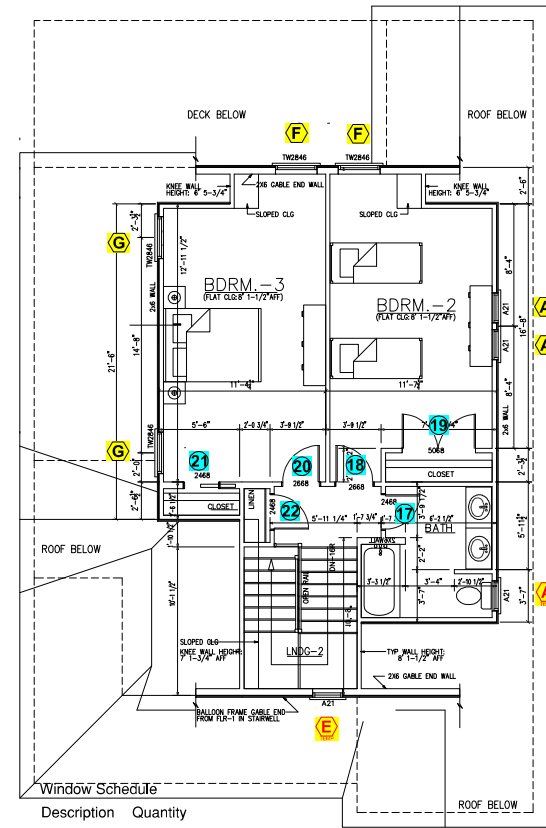

**SECOND FLOOR PLAN**

SCALE: 1/4"=1'0"

**SECOND FLOOR NOTES**

CEILING HEIGHT: 8'-1-1/2" (typical)  
 WALL HEIGHT: 8'-1-1/2" (typical)  
 EXTERIOR WALL FRAMING: 2"x4" STUDS@16" O.C. (u.n.o.)  
 INTERIOR WALL FRAMING: 2"x4" STUDS@16" O.C. (u.n.o.)  
 FLOOR SYSTEM: (see floor-2 framing for details)  
 CEILING SYSTEM: (see ceiling framing plan)  
 BEAMS/GIRDERS: (n/a)  
 PLINGS-DECK&HOUSE: 6"-10" A.F.F. (u.n.o.)  
 WINDOW HEADERS: SEE DETAILS D-5 or E-5

**SECOND FLOOR AREAS**

TOTAL AREA: 1609 sq. ft.

Window Schedule

| Description | Quantity |
|-------------|----------|
| Mark A-Temp | 3        |
| Mark A      | 7        |
| Mark B      | 2        |
| Mark C      | 1        |
| Mark D      | 5        |
| Mark E Temp | 1        |
| Mark F      | 2        |
| Mark G      | 2        |

P.O. Box 1129  
 4425 N. CREATAN HWY  
 (252) 261-4151  
 (252) 261-4153  
 C-0836



COASTAL ENGINEERING & SURVEYING, INC.  
 4425 N. CREATAN HWY  
 (252) 261-4151  
 (252) 261-4153  
 C-0836

REVISIONS

| NO. | DATE     | DESCRIPTION |
|-----|----------|-------------|
| 1   | 11/11/21 | AS BUILT    |

NORTH CAROLINA  
 REGISTERED PROFESSIONAL ENGINEER  
 EXPIRATION DATE: 12/31/2024

**BAILEY RESIDENCE**  
 CRYSTAL LAKE COURT  
 LOT 32, PHASE I, THE VILLAGES AT OCEAN HILL  
 PINEBLAKE VILLAGE WITH FIRST FLOOR FRAMING PLAN

DATE: 11/11/21  
 CHECKED: CG  
 PROJECT NO: J1869.21  
 CAP FILE: J1869.21  
 SHEET: D2

D2 of D2